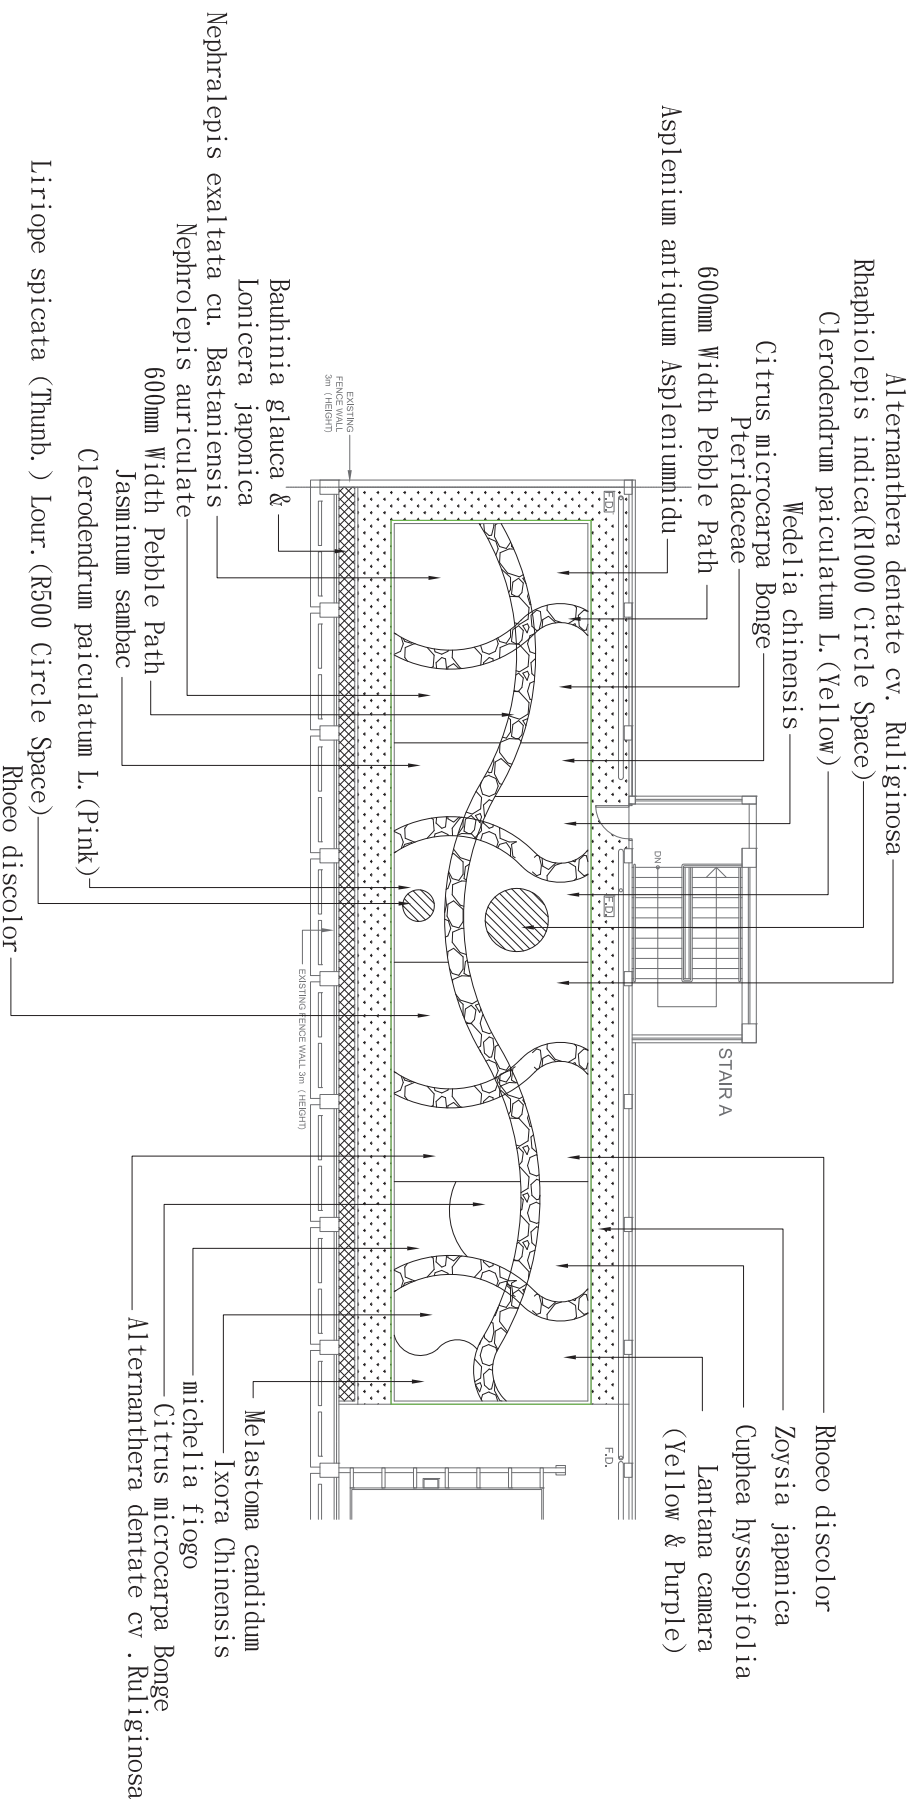


[illegible]

Proposed Planting Pattern

NO.	Date	Description	h/b
B	06-12-10	AS-BUILT	
A	06-1-10	FOR COMMENT	
0	22-10-10	FOR COMMENT	

	Name	Date
Landscape Architect		
Drawn	HW Cheung	08-12-1
Checked	John Yau	08-12-1

TWGHS Chen Zao Men College

Contract No:

File No. ---

Project No. ---

Contract :

GREEN AND ENERGY SAVING PROJECT (GREEN ROOF)

TWGHS CHEN ZAO MEN COLLEGE

Drawing Title:

PLANTING SCHEDULE

TGWGHS CHEN ZAO MEN COLLEGE

Drawing No.	Revision
-------------	----------

CZM-PLAN I-001



Hong Kong Greenlink Kùsters

香港綠色鏈接庫斯有限公司

Downloaded from ascelibrary.org by University of California, San Diego on 06/01/15. Copyright ASCE, For All Rights Reserved, No part of this document may be reproduced, stored in a retrieval system, or transmitted, in any form or by any means, electronic, mechanical, photocopying, recording, or by any information storage or retrieval system, without permission in writing from ASCE.